



AMENDED PLAN
FAREHAM BOROUGH COUNCIL
Development Management

Received: **05 FEB 2014**
Reference: **P/14/0081/FP**

Decision: **APPROVE**
Decided: **02-MAY-2014**

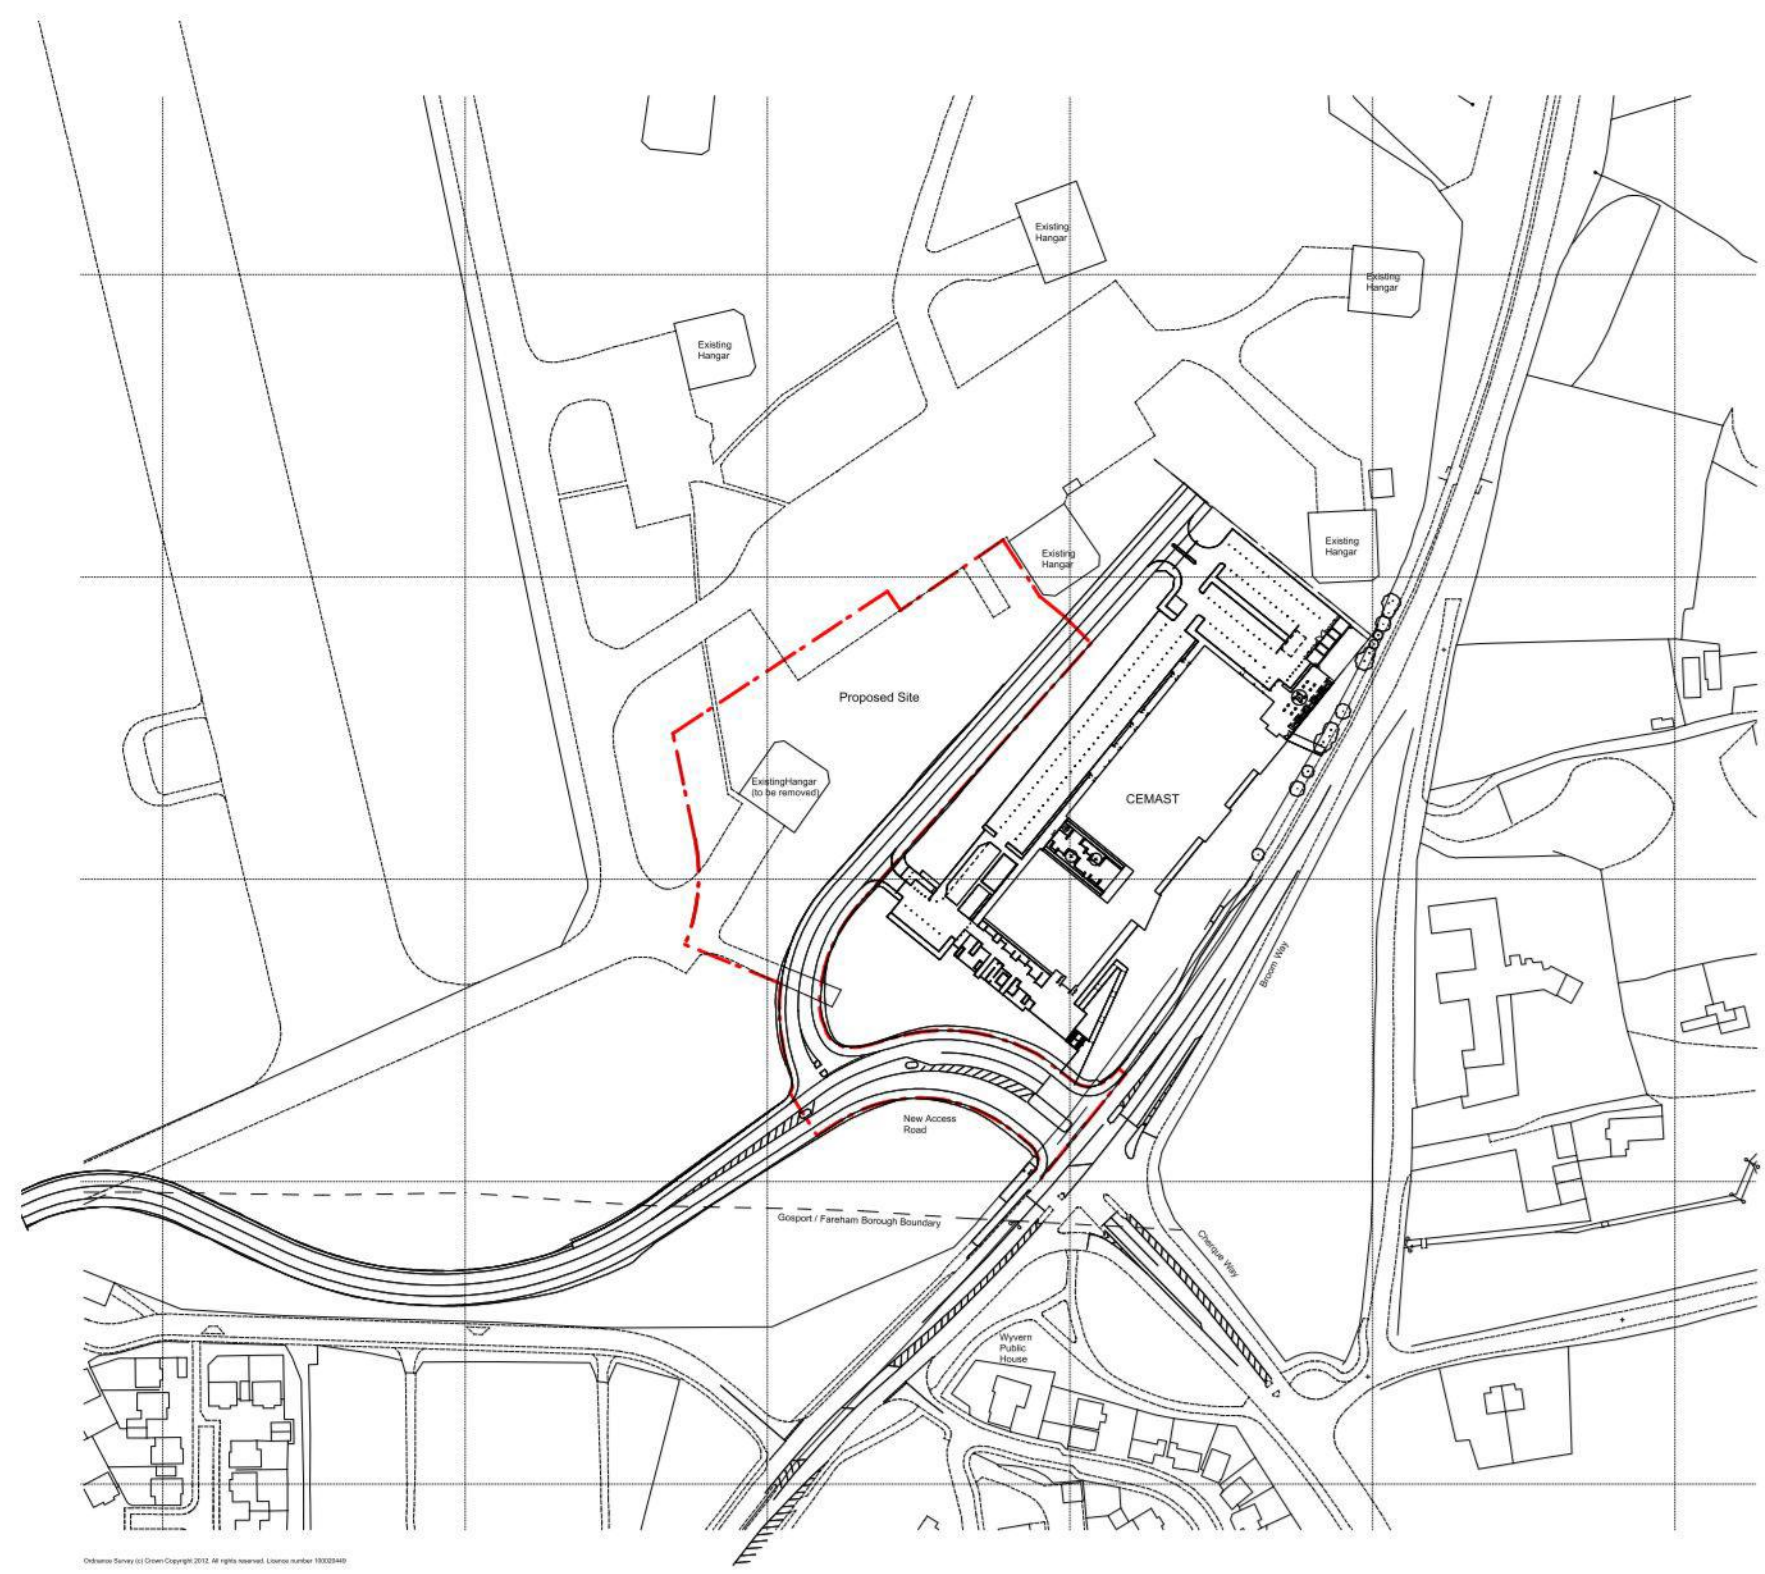

rev	date	description	drw	chkd
A	05/02/2014	Red line boundary updated to meet public highway	MD	NJC

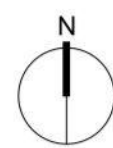

PLANNING APPLICATION DRAWING

Perkins | Ogden Architects Construct House Winchester Road Alresford SO24 9EZ
Tel (01962) 735155 Fax (01962) 734305

SHEET CONTENTS
Fareham Borough Council, Innovation Centre, Solent Enterprise Zone, Daedalus, Lee-On-Solent
Existing Location Plan

SCALE	CREATED	DRAWN	DRAWING NO.	REVISION
1:1250 @ A1 1:2500 @ A3	01/14	POA	5258/PL/1.001	A