


AMENDED PLAN
FAREHAM BOROUGH COUNCIL
Development Management
Received: **05 FEB 2014**
Reference: **P/14/0081/FP**

Decision:
Decided:

SUPERSEDED

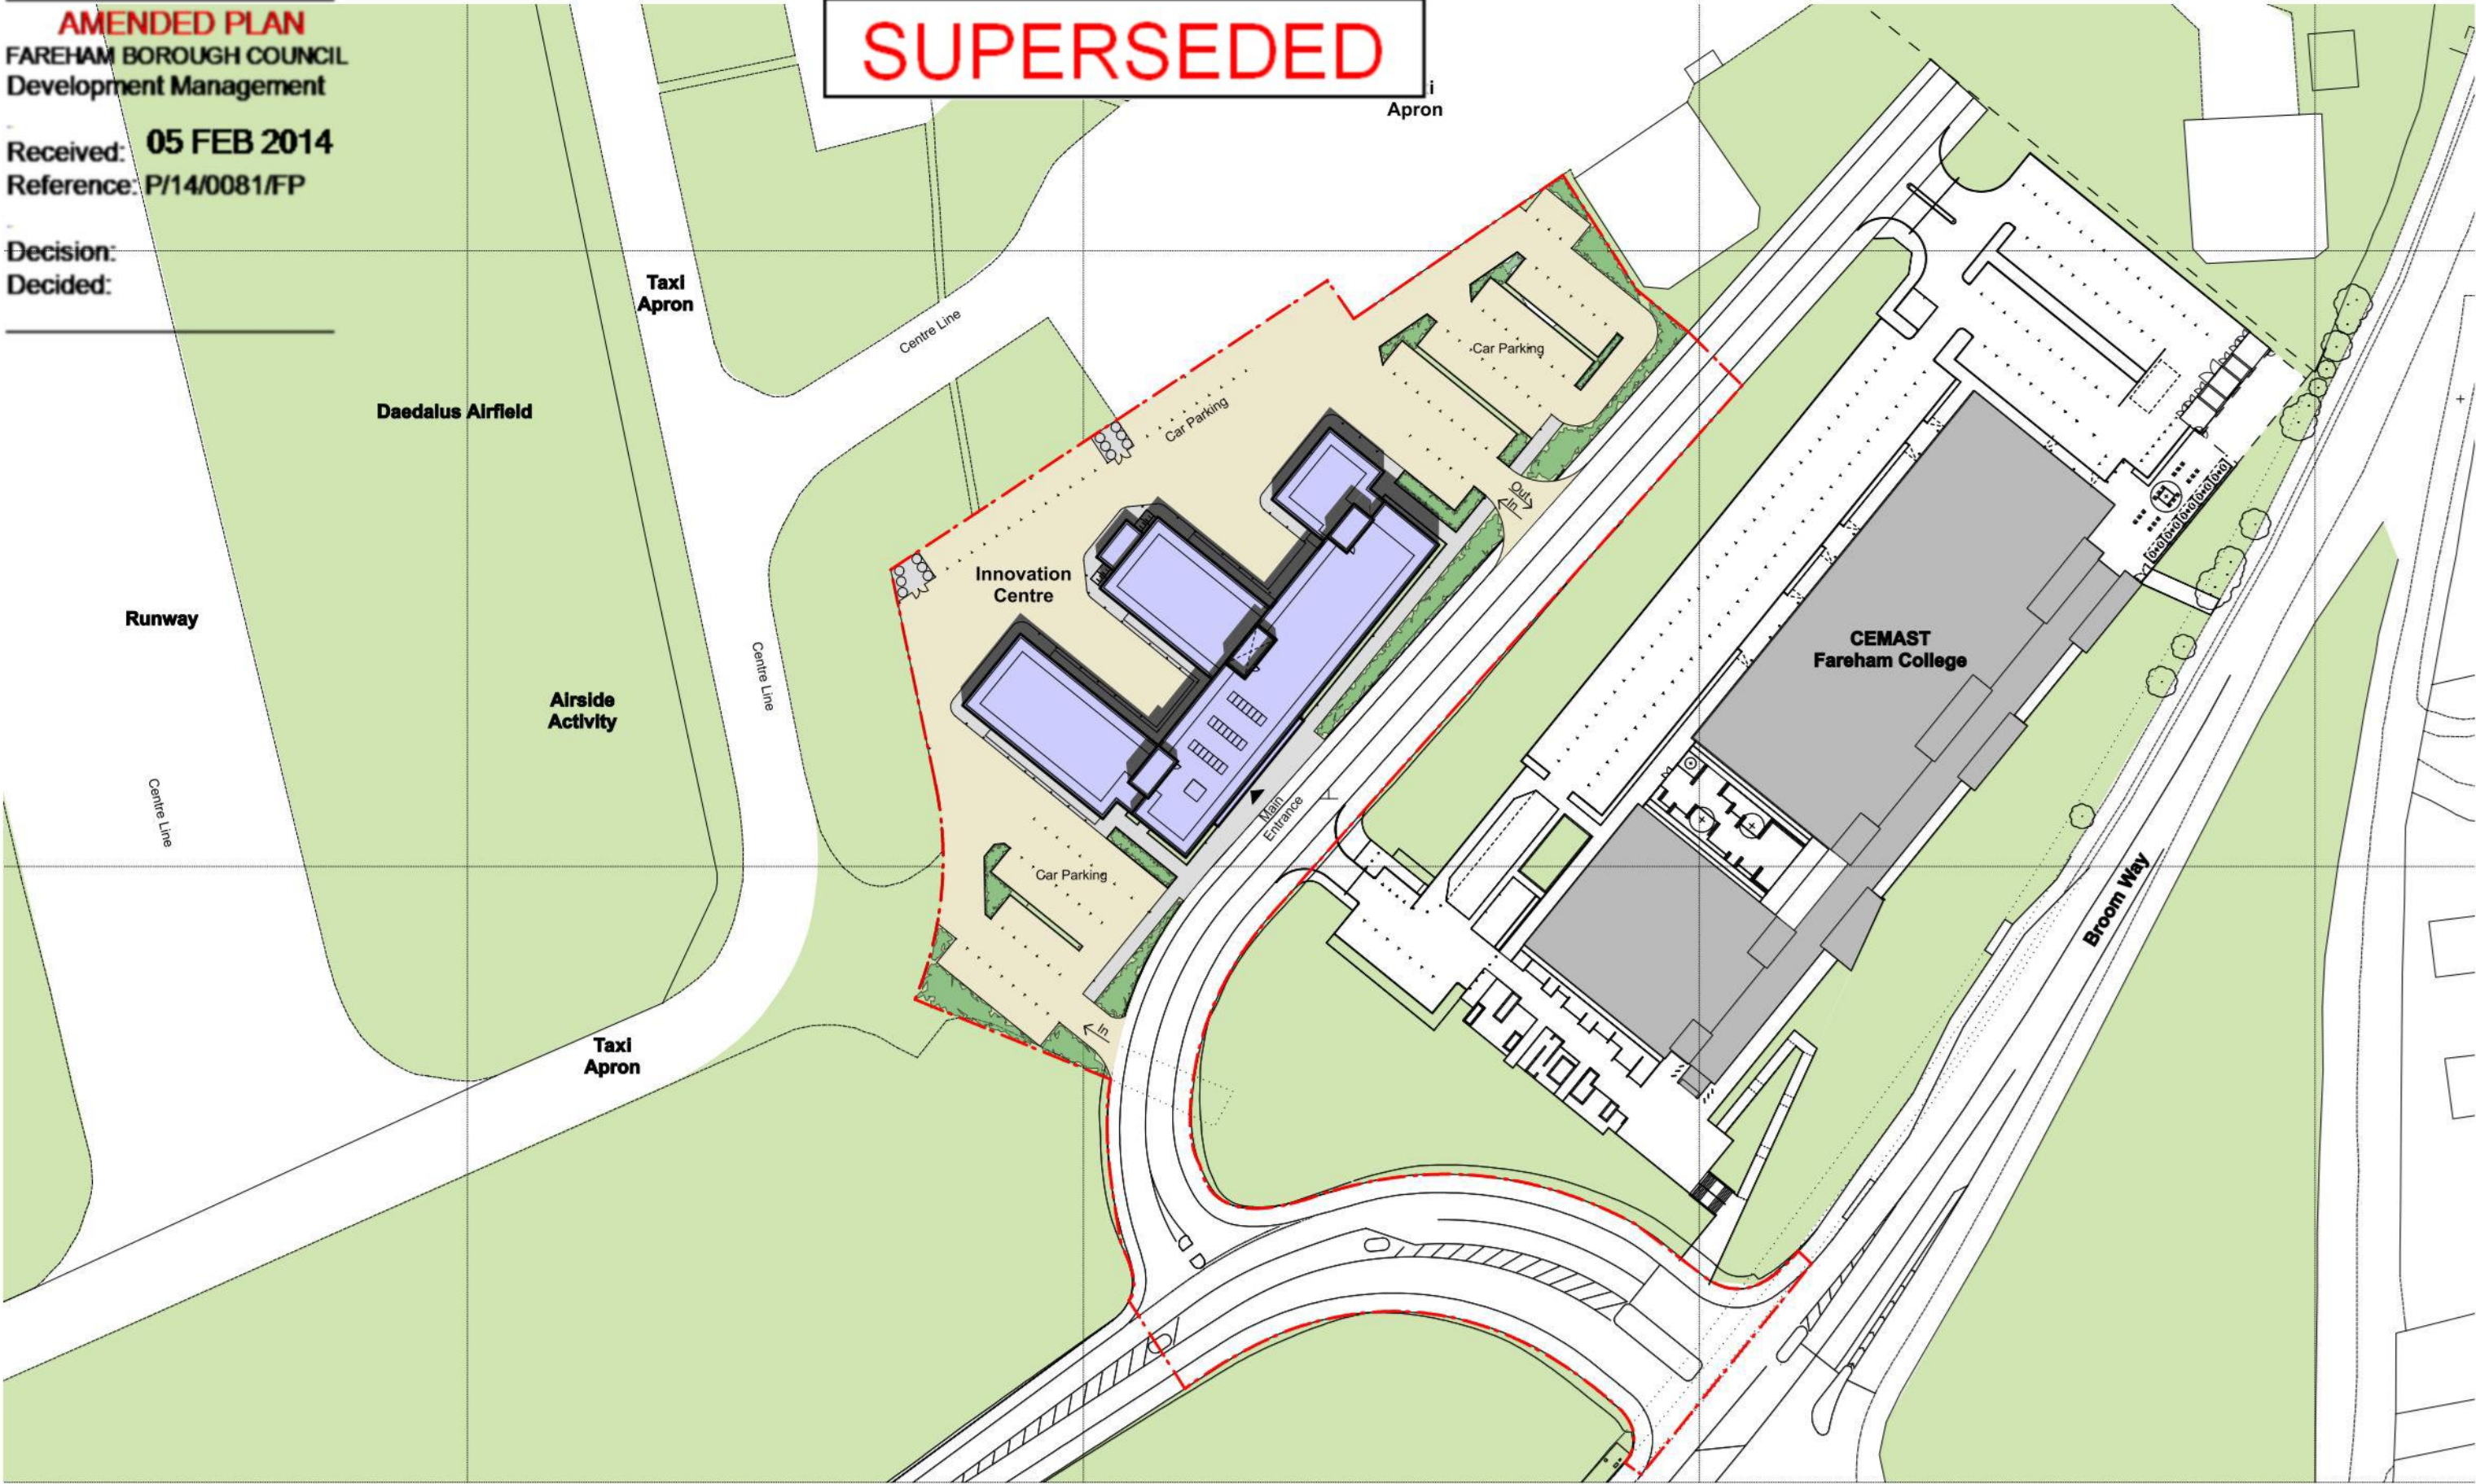

rev	date	description	drw	chkd
A	05/02/2014	Red line boundary updated to meet public highway	MD	NJC



PLANNING APPLICATION DRAWING

Perkins | Ogden Architects

Construct House Winchester Road Alresford SO24 9EZ
Tel (01962) 735155 Fax (01962) 734305

SHEET CONTENTS

Fareham Borough Council, Innovation Centre, Solent Enterprise Zone, Daedalus, Lee-On-Solent
Proposed Site Plan

SCALE

1:500 @ A1
1:1000 @ A3

CREATED

01/14

DRAWN

POA

DRAWING NO.

5258/PL/1.003

REVISION

A