



**AMENDED PLAN**  
FAREHAM BOROUGH COUNCIL  
Development Management

Received: 24 MAR 2014  
Reference: P/14/0081/FP

Decision: APPROVE  
Decided: 02-MAY-2014

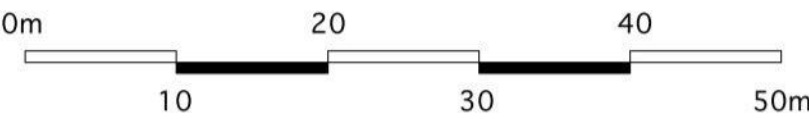

rev	date	description	drw	chkd
A	05/02/2014	Red line boundary updated to meet public highway	MD	NJC
B	21/03/14	1 No. bin store removed, Car park rearranged, Roof plan updated (see 5258/PL/1.006 Rev A), motorcycle parking shown	MD	NJC

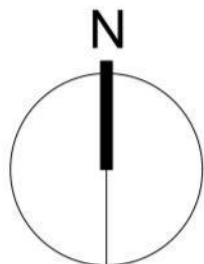

PLANNING APPLICATION DRAWING

Perkins | Ogden Architects  
Construct House Winchester Road Alresford SO24 9EZ  
Tel (01962) 735155 Fax (01962) 734305

SHEET CONTENTS  
Fareham Borough Council, Innovation Centre, Solent Enterprise Zone, Daedalus, Lee-On-Solent  
Proposed Site Plan

SCALE	CREATED	DRAWN	DRAWING NO.	REVISION
1:500 @ A1 1:1000 @ A3	01/14	POA	5258/PL/1.003	B